

# E LAFAYETTE ST

# 1057


## GOODBODY LN/ SEMINOLE DR/ HOLLAND DR

DRAWN BY: DMR

DATE: 2/9/12

REV DATE:

WELL NO. :

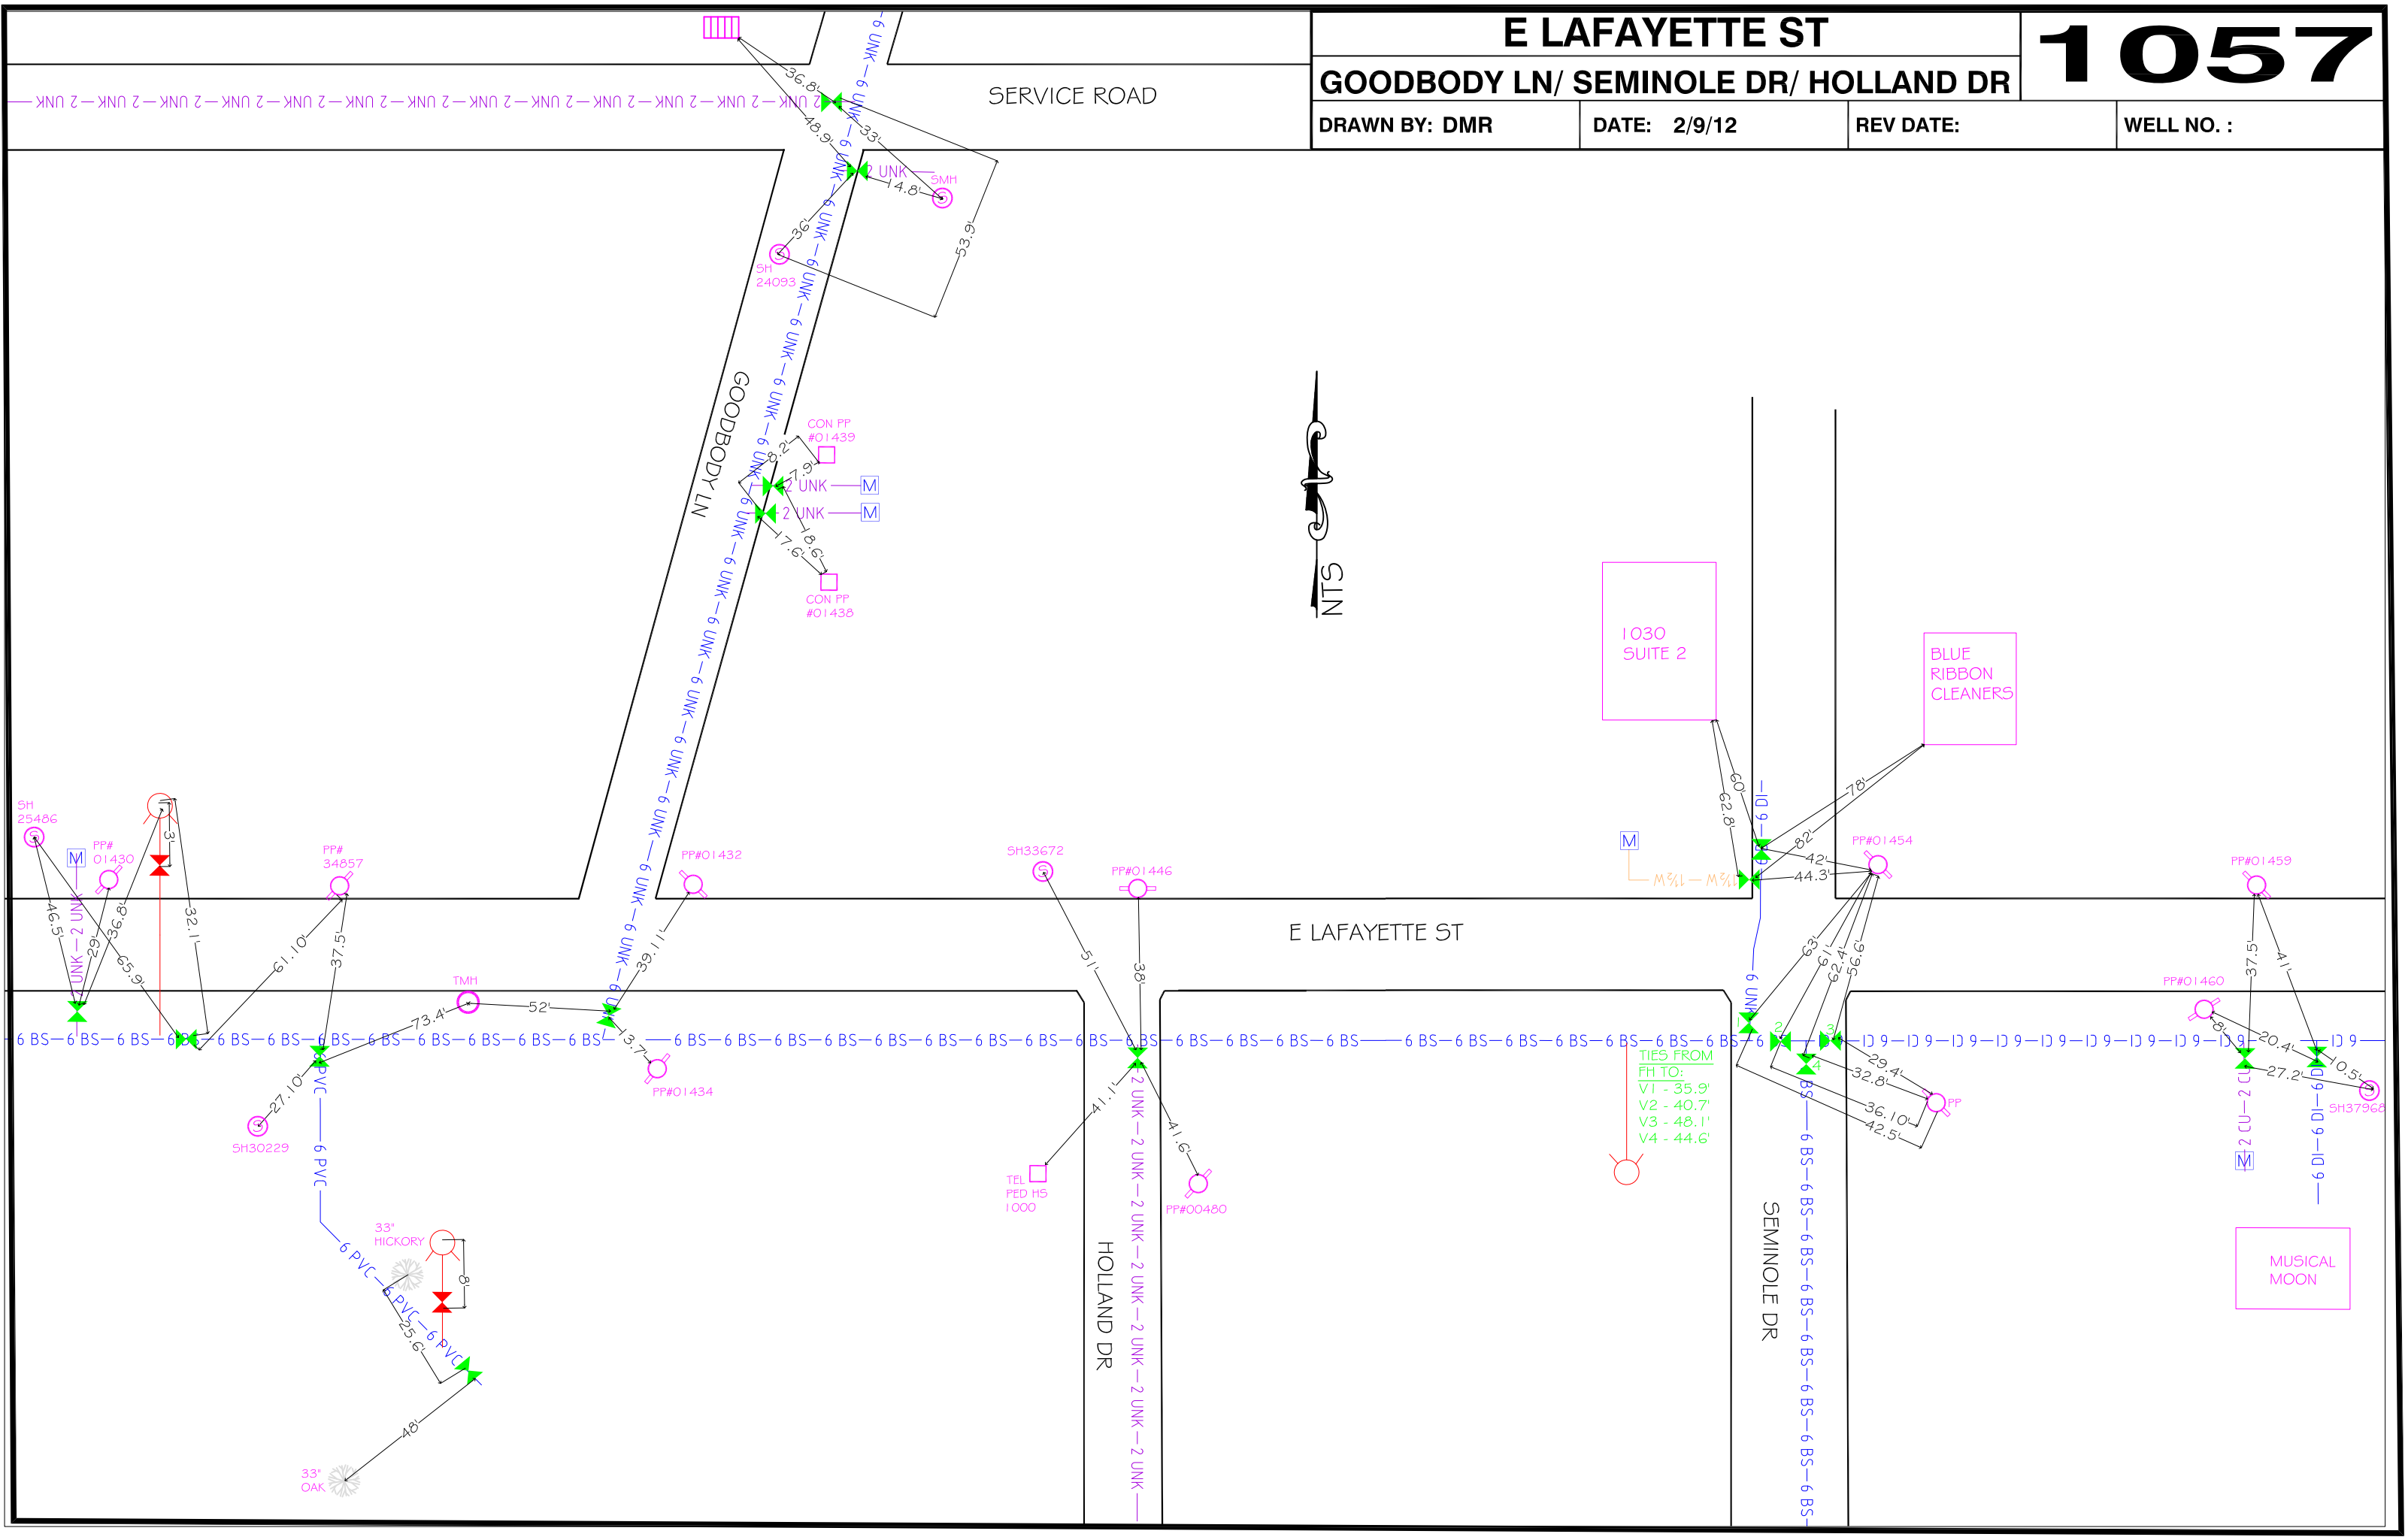

TIES FROM  
FH TO:  
V1 - 35.9'  
V2 - 40.7'  
V3 - 48.1'  
V4 - 44.6'