

MATCHLINE SEE SH2498

WATER TIE SHEET

2500

E LAFAYETTE ST. / MAGNOLIA DR.

DRAWN BY: DJL III

DATE: 7/28/11

REV DATE: 7/28/11


WELL NO. :

MATCHLINE

SEE SH1058

MATCHLINE

SEE SH2501

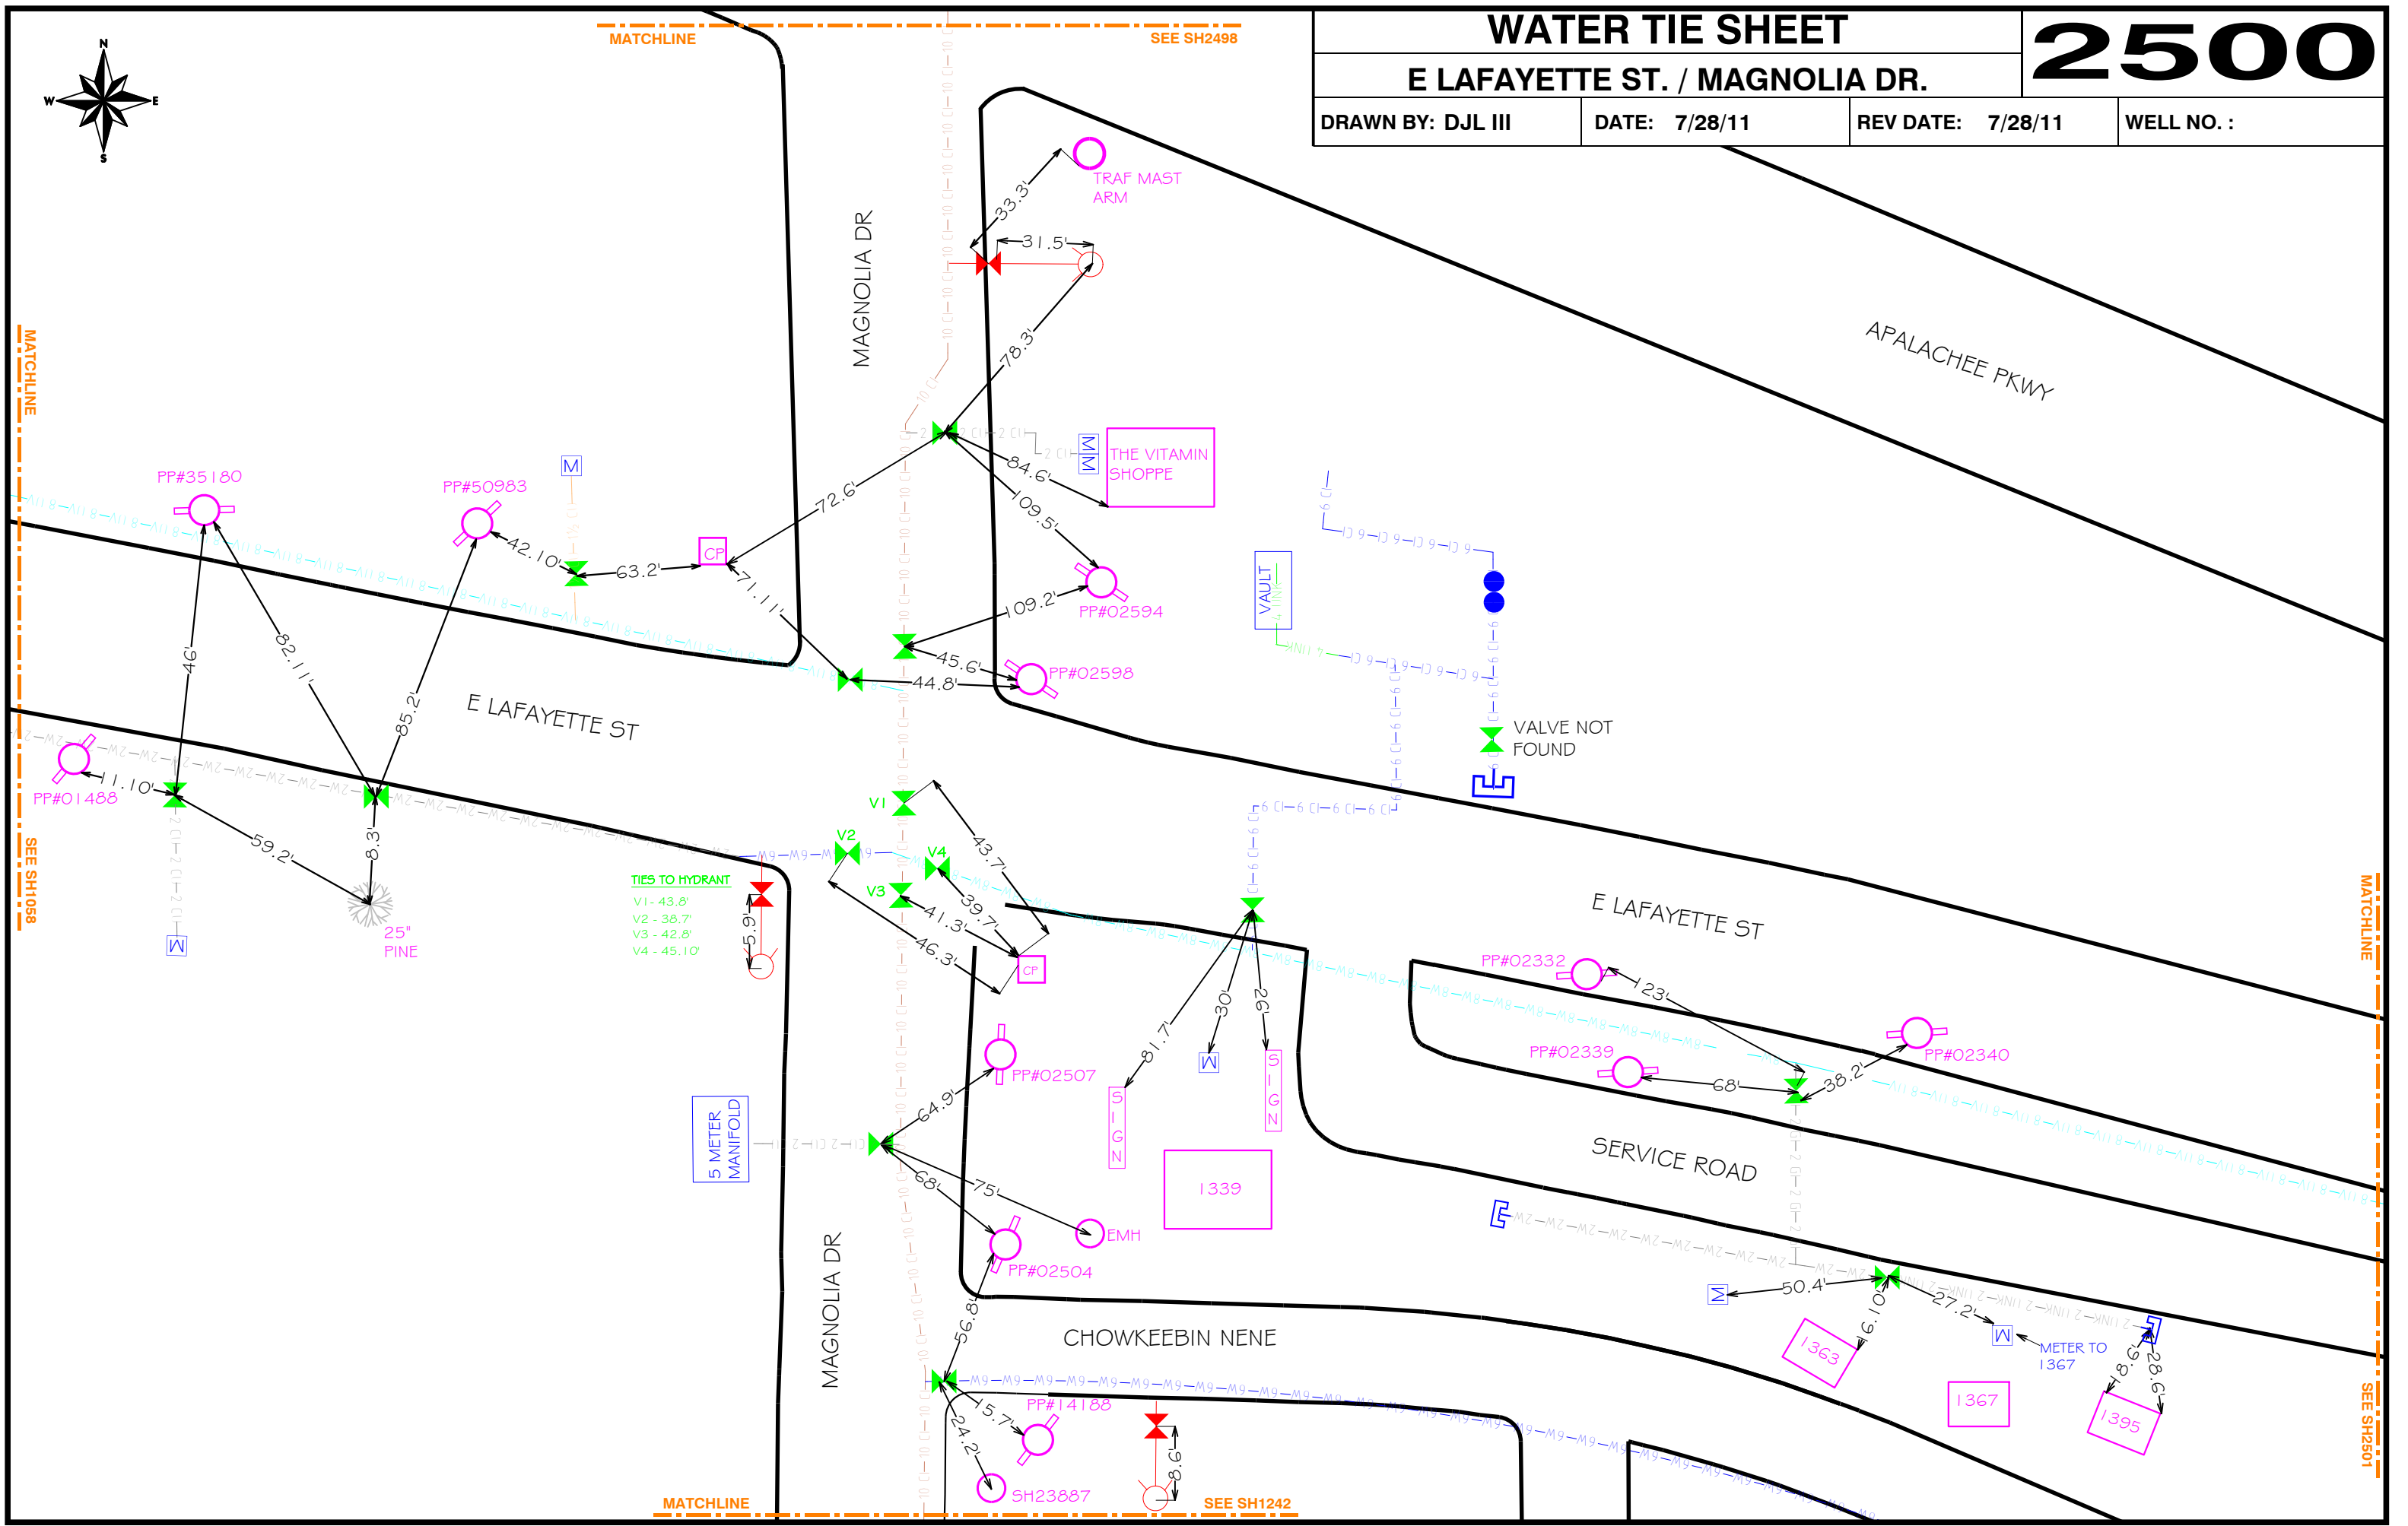

TIES TO HYDRANT
 V1 - 43.8'
 V2 - 38.7'
 V3 - 42.8'
 V4 - 45.10'

5 METER
 MANIFOLD

1339

1363

1367

1395

CHOWKEEBIN NENE

SERVICE ROAD

E LAFAYETTE ST

MAGNOLIA DR

E LAFAYETTE ST

MAGNOLIA DR

APALACHEE PKWY

TRAF MAST
 ARM

THE VITAMIN
 SHOPPE

VALVE NOT
 FOUND

VAULT

MATCHLINE

SEE SH1242