

CHOWKEEBIN NENE/ APAKIN NENE

2134



OLD ST AUGUSTINE RD/ E LAFAYETTE ST

DRAWN BY: DMR

DATE: 4/12/12

REV DATE:

WELL NO. :

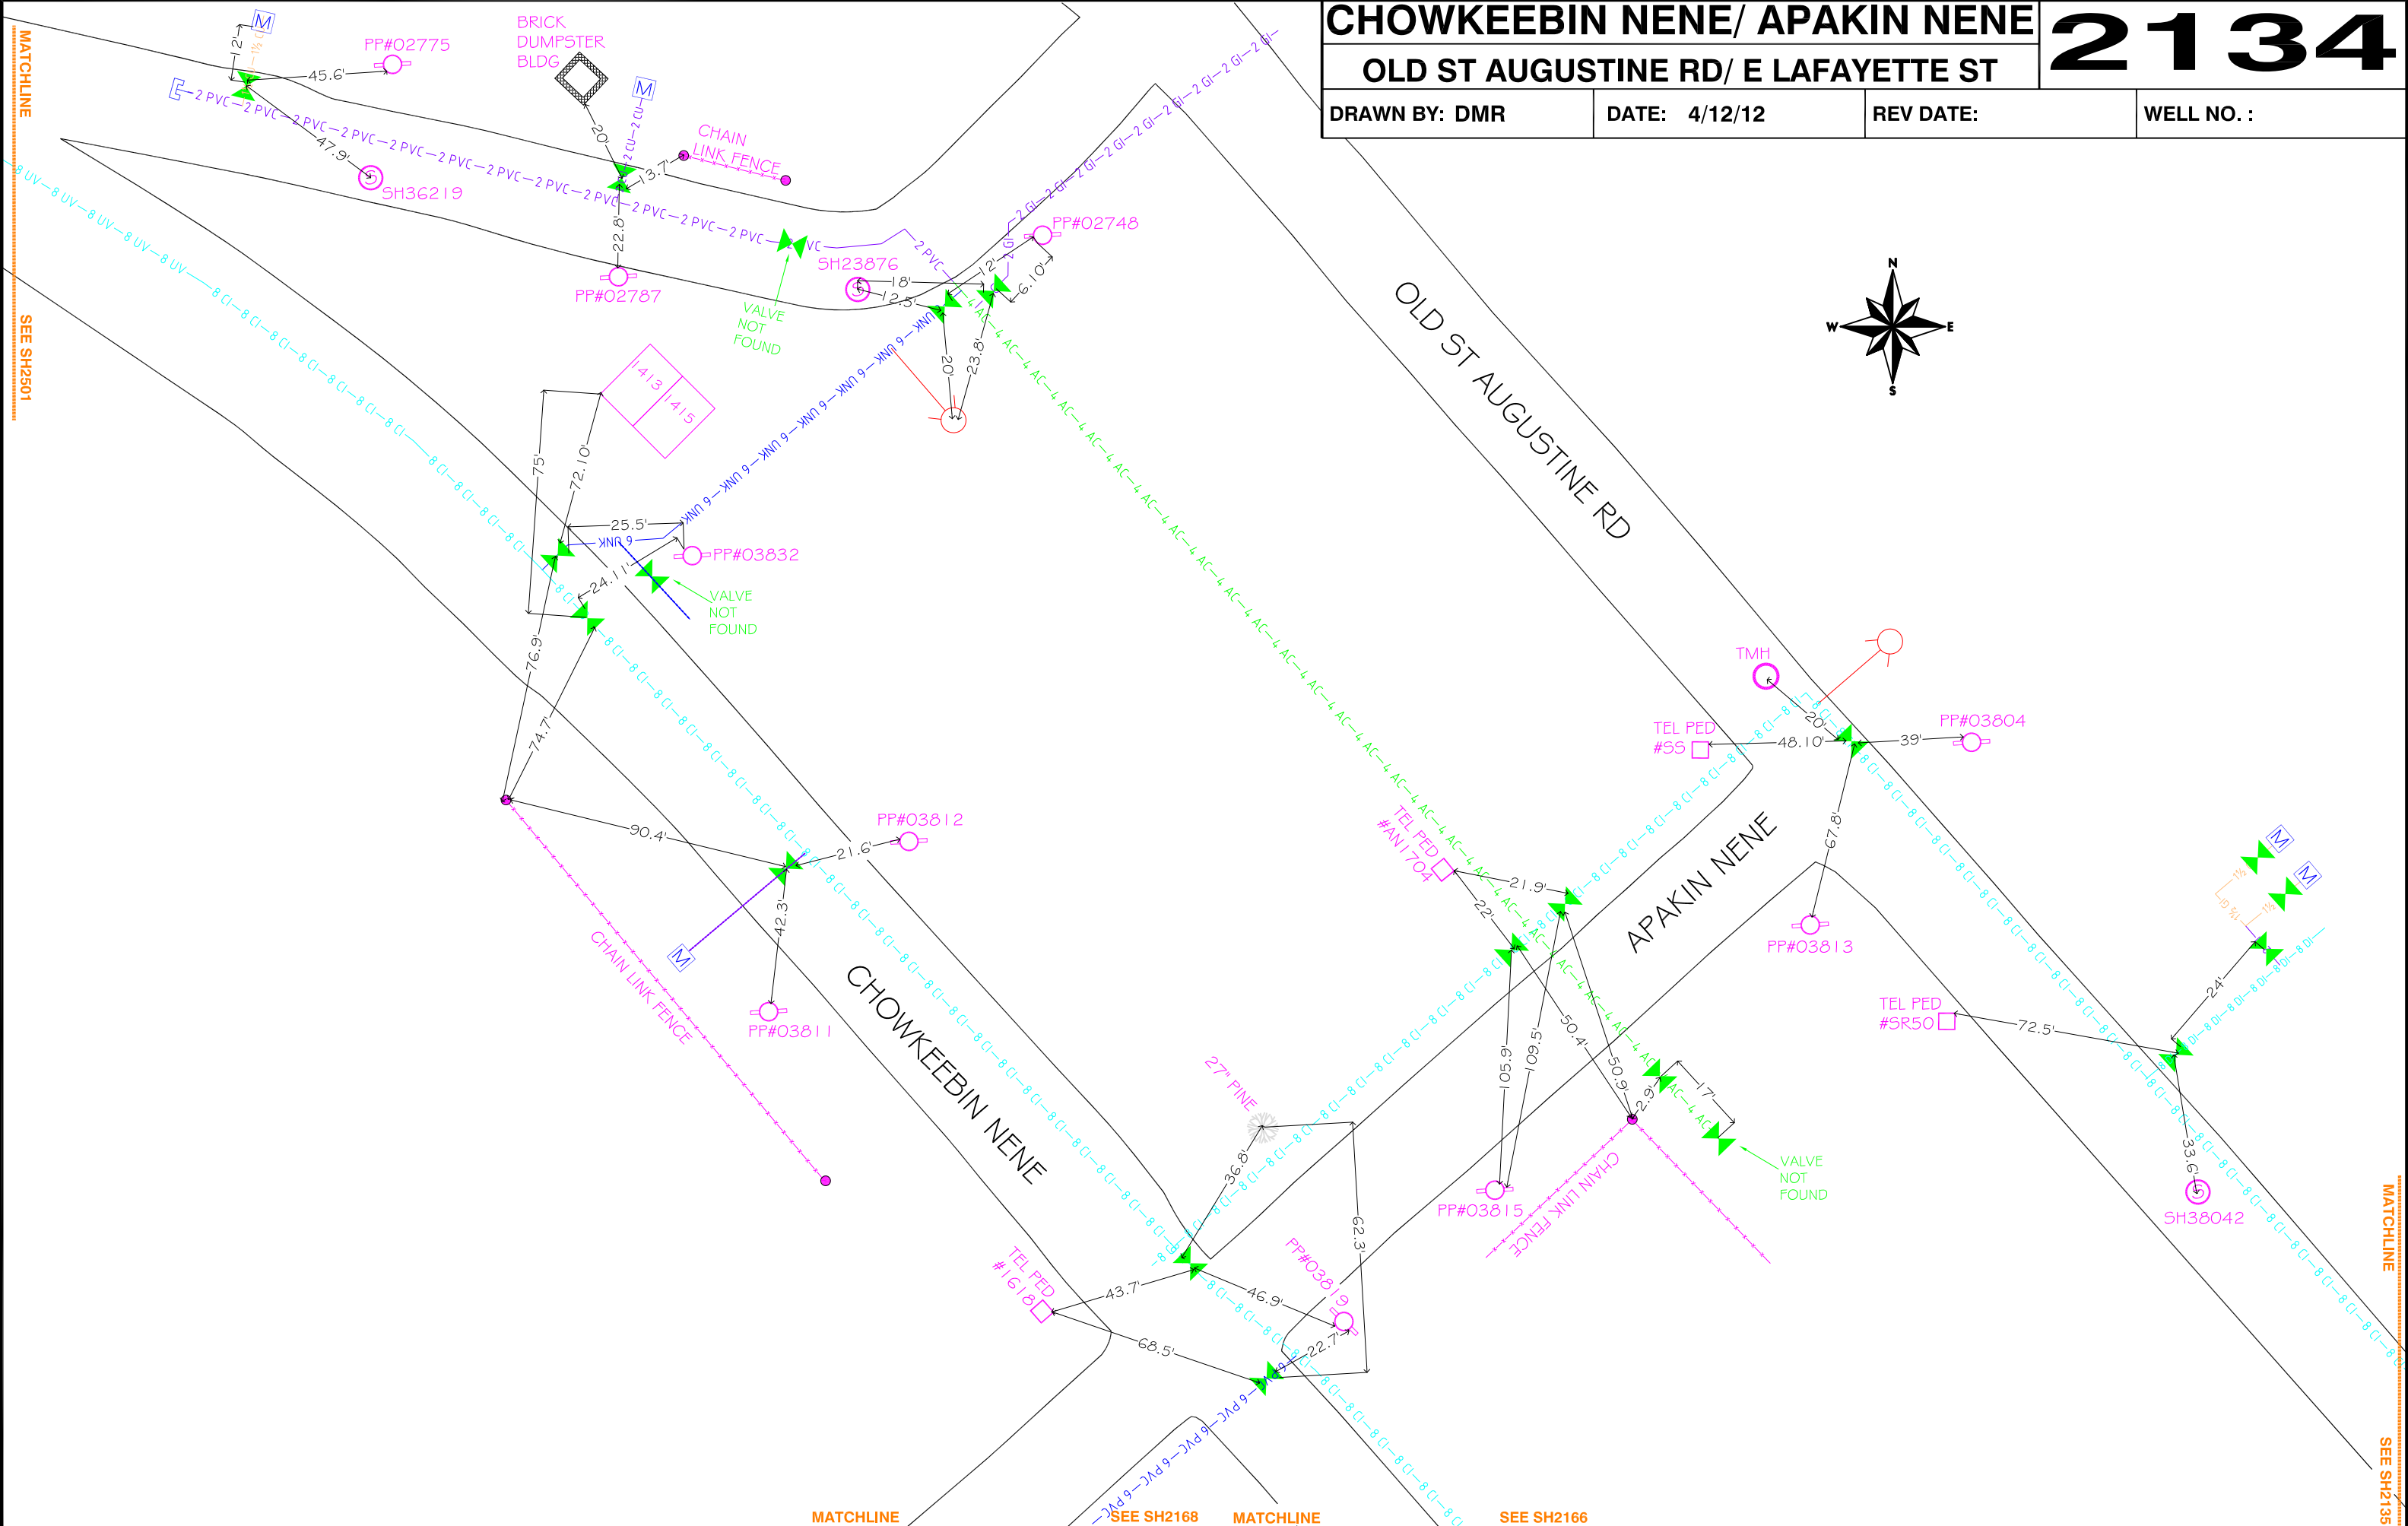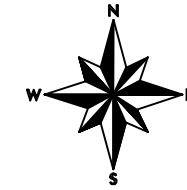

MATCHLINE
SEE SH2501

MATCHLINE SEE SH2168 MATCHLINE SEE SH2166

MATCHLINE
SEE SH2135