WATER TIE SHEET

E LAFAYETTE ST

1058
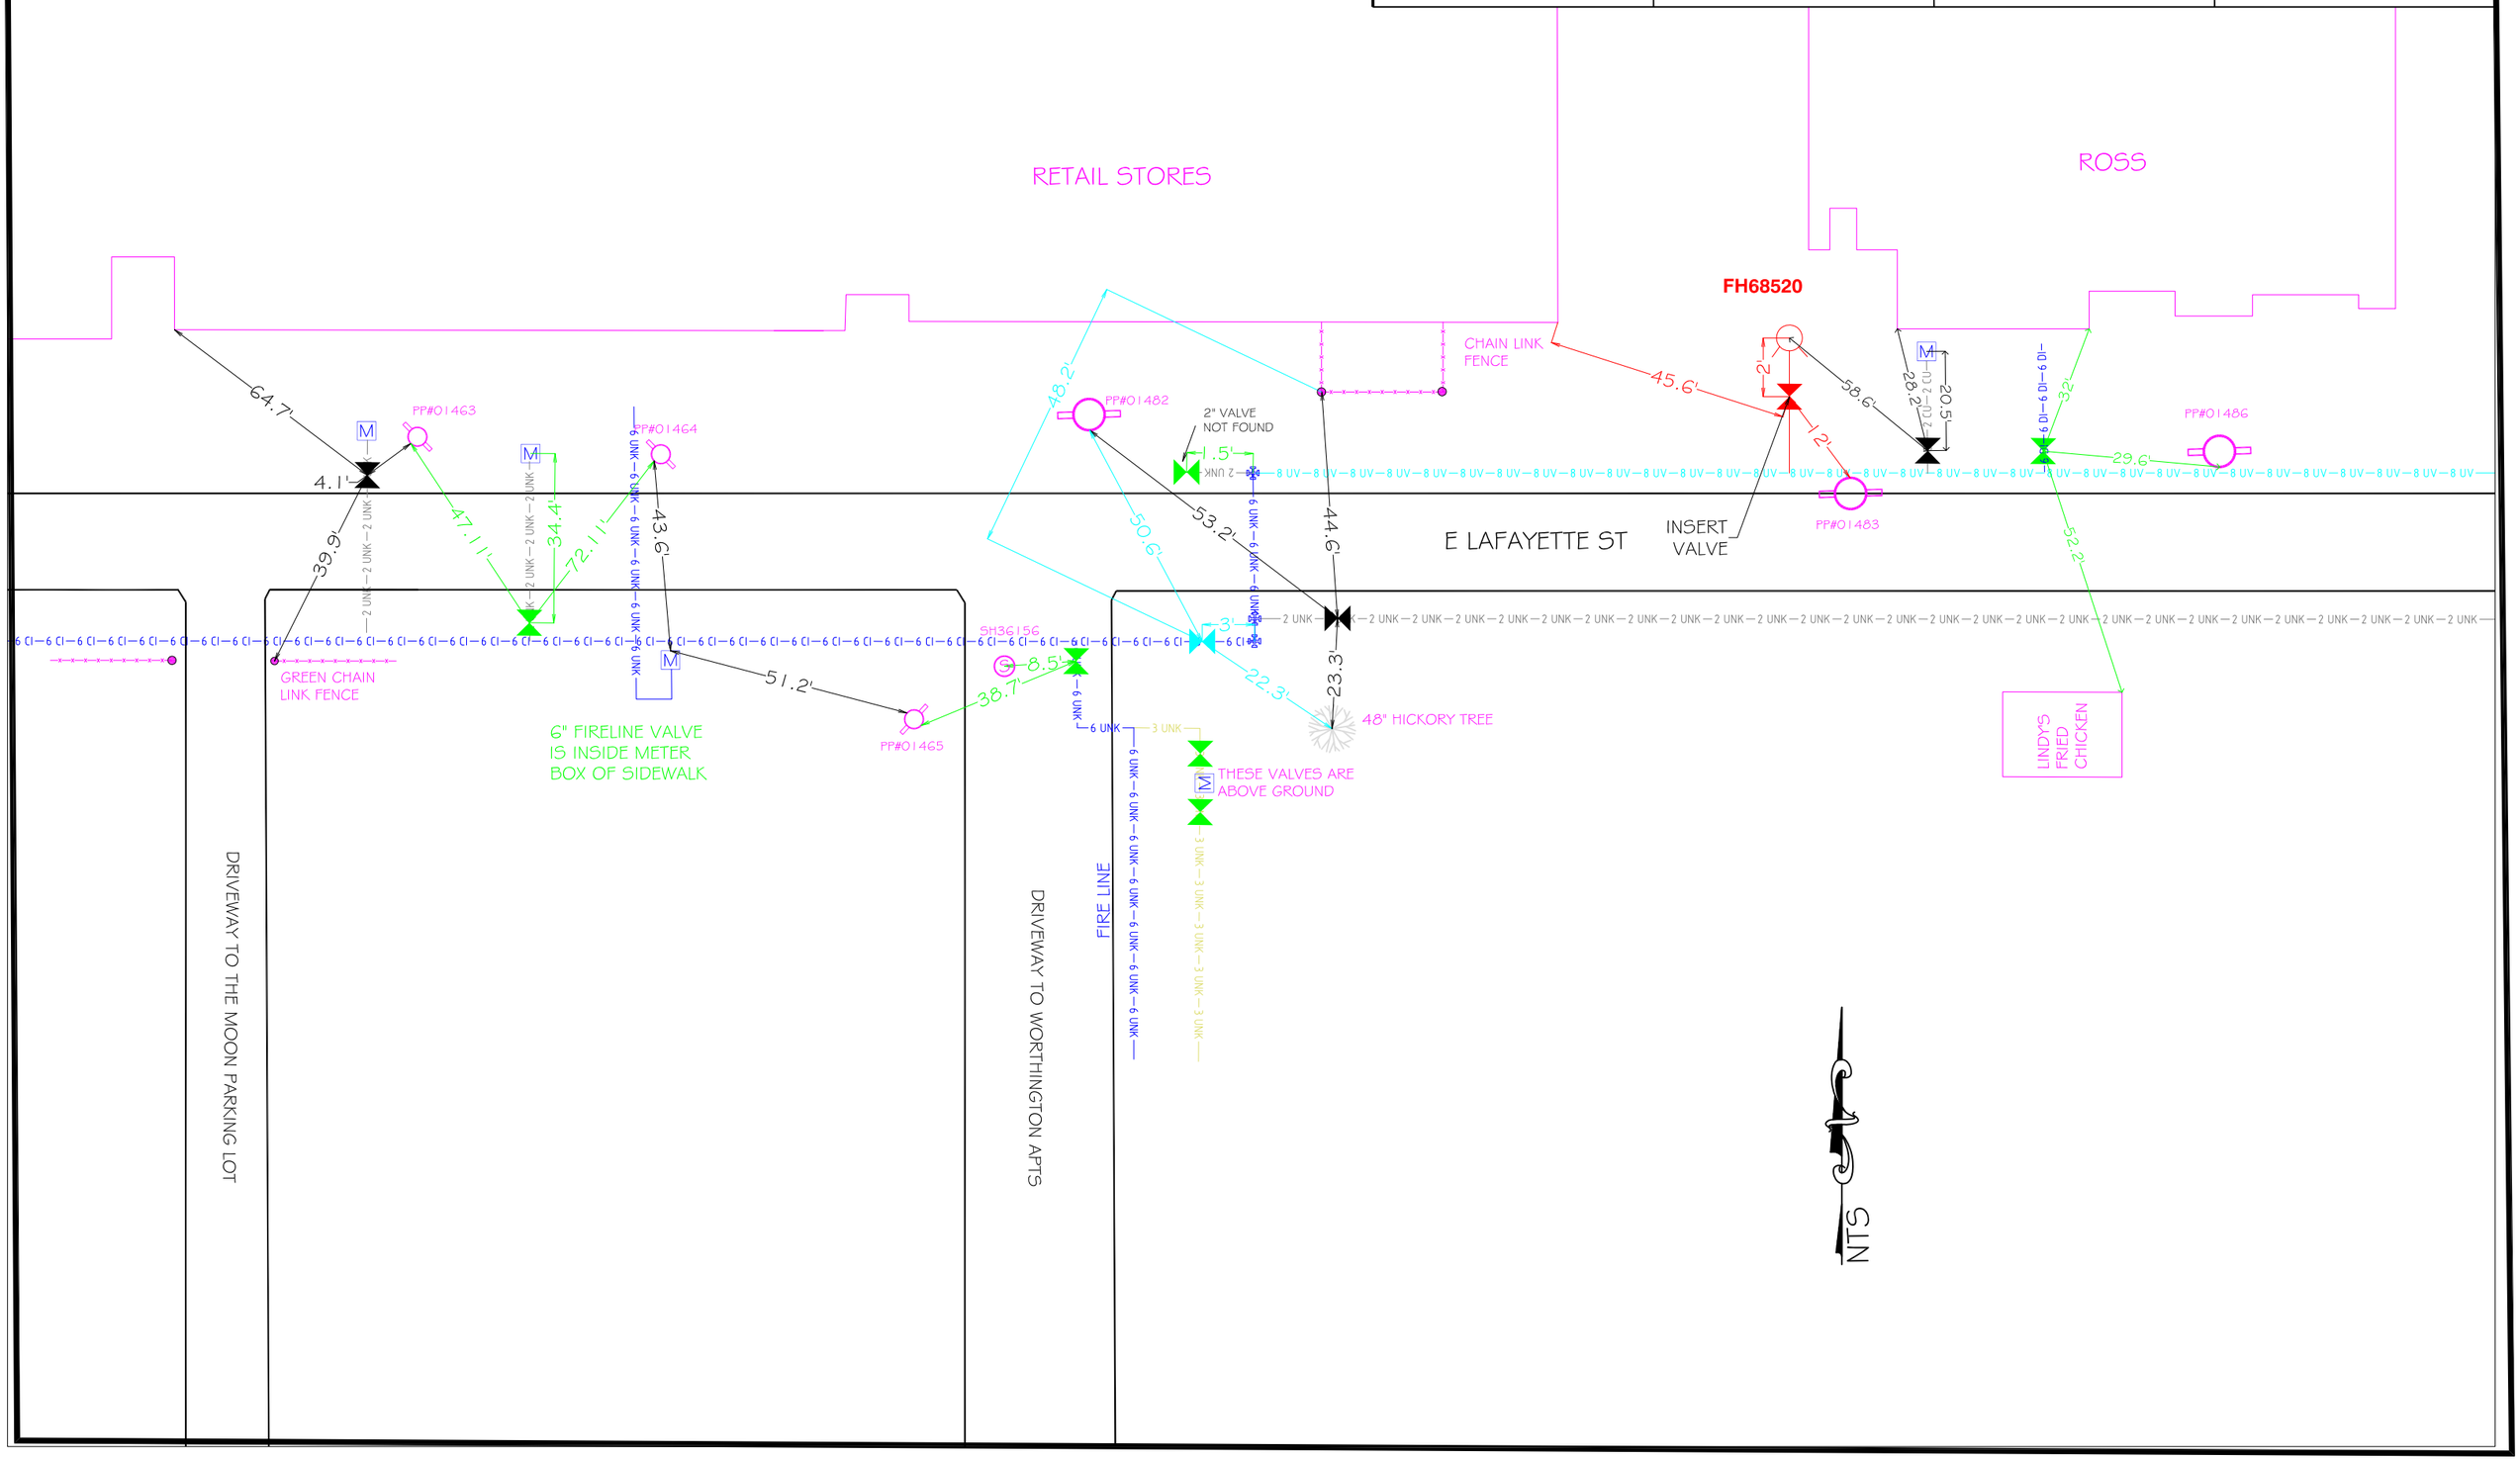
DRAWN BY: DJL III	DATE: 7/28/11	REV DATE: 10/2/12	REV BY: JMS